

IREDELL COUNTY HEALTH DEPARTMENT

IMPROVEMENT PERMIT / AUTHORIZATION TO CONSTRUCT / OPERATION PERMIT / EXISTING SYSTEM INSPECTION

PERMIT# 111 339 PIN# 4637-07-2968 STATESVILLE 704-878-5305 130.00 Paid MOORESVILLE 704-664-5281 DATE 3/2/03 10:00

OWNER OR CONTRACTOR Vasile Lazar PHONE: Business 704-906-5102 Home _____

ADDRESS 131 Sage More St. Troutman NC 28116

LOCATION 150 W. TL Quiet Cove, on corner w/ Ridgeway

SUBDIVISION Spring Acres BLOCK / SECTION _____ LOT 32 LOT AREA 0.55 AC. SITE CLASS. PS DESIGN FLOW 360 L.T.A.R. 0-3

Septic Tank: 1000 Gallons; STB 1012 Date 4/9/03
 Pump Tank: _____ Gallons; PT _____ Date _____
 Pump Make: _____ Model _____ Serial No. _____
 Nitrification Field: No Fields _____ Square Feet 900 Linear Feet 300
 No Lines 3 Trench Width 36" Max Trench Bottom Depth 36"

☒ New System ☐ Repair System Type: I, II, III, IV, V, VI
 System Description: Gravity 25% Reduc.
 Repair System Description: 25% Reduc.
 Maintenance Agreement Required: ☐ Yes ☒ No


☒ House/Mod. Home No. Bedrooms 3
☐ Mobile Home No. Bathrooms 2
☐ Business No. Employees _____
☐ Other _____

Water Supply:
☒ Individual
☐ Public
☐ Community


Comments/Conditions: House Plans Reviewed on site

Comments/Conditions:

INITIAL SITE SKETCH 1"=50'

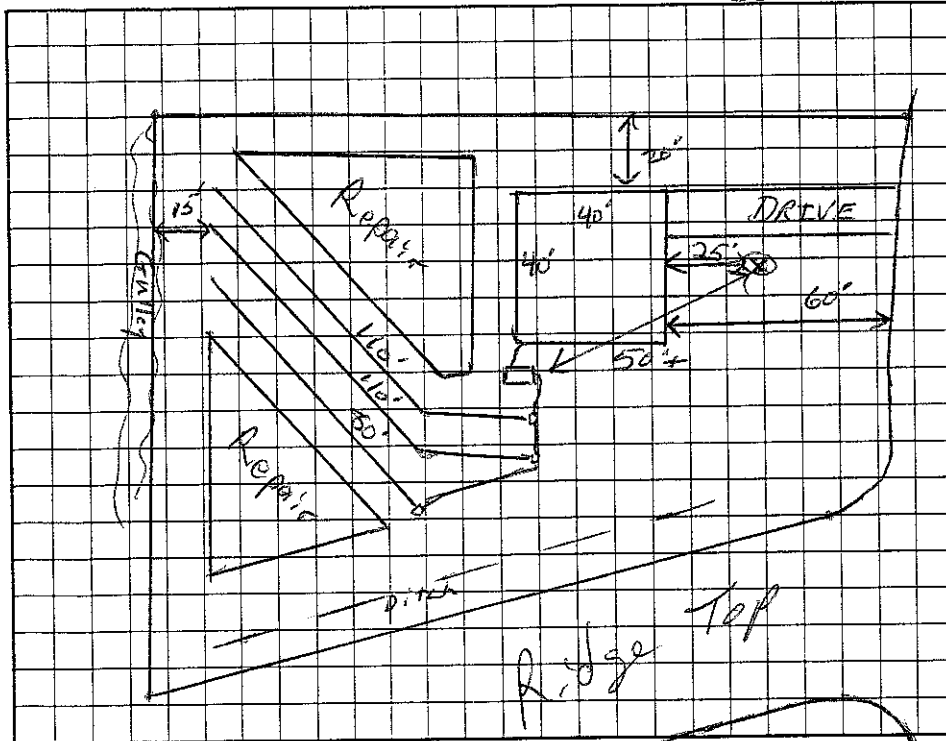

AS BUILT SKETCH

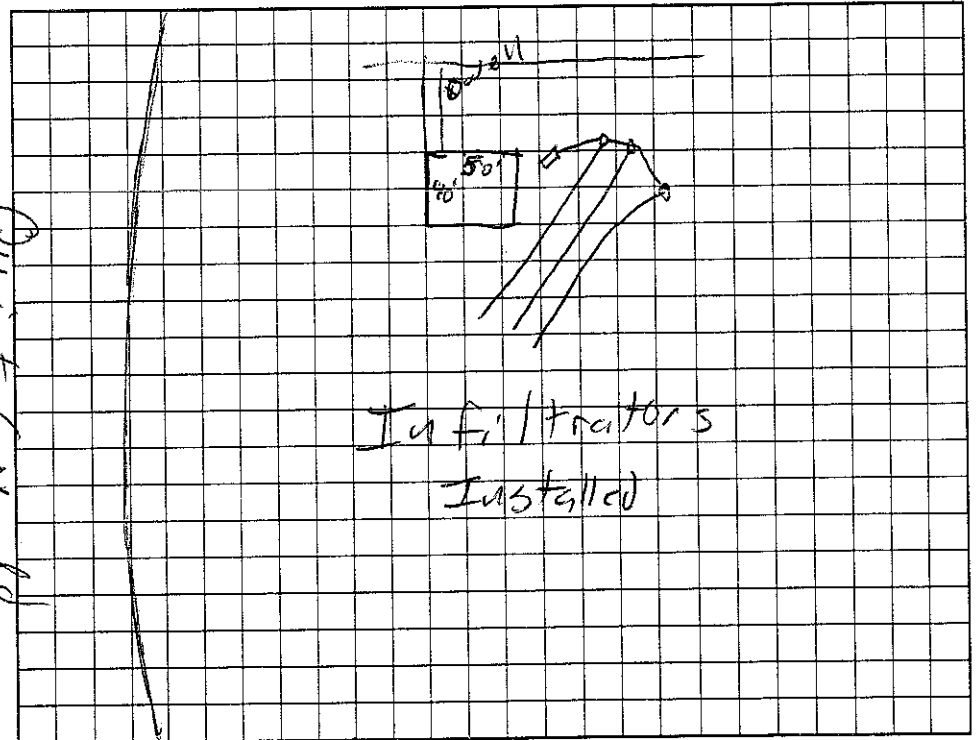

Permit can be suspended or revoked if any false information is supplied toward securing the permit/any unauthorized changes are made to the site/any unauthorized changes are made in the installation of the system. Improvement Permit with plat valid without expiration. Improvement Permit with site plan valid for sixty months. Authorization to Construct is valid for a period equal to that of Improvement Permit - not to exceed sixty months.

Signed: Vasile Lazar date 03-10-03 Installed by: Tommy Faye

Improvement Permit by: G. Murray RS date 3/7/03 Operation Permit by: G. Murray RS date 10/15/03

Authorization to Construct by: G. Murray RS date 3/7/03 Existing System Inspection by: _____ date _____