

IREDELL COUNTY HEALTH DEPARTMENT

STATESVILLE 704-878-5305

MOORESVILLE 704-664-5281

IMPROVEMENT PERMIT / AUTHORIZATION TO CONSTRUCT / OPERATION PERMIT / EXISTING SYSTEM INSPECTION

PERMIT# 108402 PIN# 4637-07-6800 DATE 9/12/02
 OWNER OR CONTRACTOR Ronald Smith PHONE: Business _____ Home 878-3130
 ADDRESS 115 Creek View Rd Mooresville NC 28117
 LOCATION 150 W, TL Quiet Cove Rd, on Lt After Ridge Top
 SUBDIVISION Spring Acres BLOCK / SECTION _____ LOT 37 LOT AREA 0.56 AC. SITE CLASS. PS DESIGN FLOW 360 L.T.A.R. 0.3

Septic Tank: 1000 Gallons; STB 825 Date 9/20/03 ☒ New System ☐ Repair System Type: I, II, III, IV, V, VI
 Pump Tank: _____ Gallons; PT _____ Date _____ System Description: Gravity 25% Reduction
 Pump Make: _____ Model _____ Serial No. _____ Repair System Description: Pump Panel Block
 Nitrification Field: No Fields 1 Square Feet 900' Linear Feet 300' Maintenance Agreement Required: ☐ Yes ☒ No
 No Lines 5 Trench Width 36" Max Trench Bottom Depth 36" Gravel Depth _____ ☐ Slab ☒ Crawl Space ☐ Basement w/plumbing ☐ Basement wo/plumbing


Water Supply:
☒ Individual
☐ Public
☐ Community

Comments/Conditions:


Comments/Conditions:

Tank and line check 11/18/03 GM
11/21/03 Checked lines 2 + 3 - AWS

INITIAL SITE SKETCH

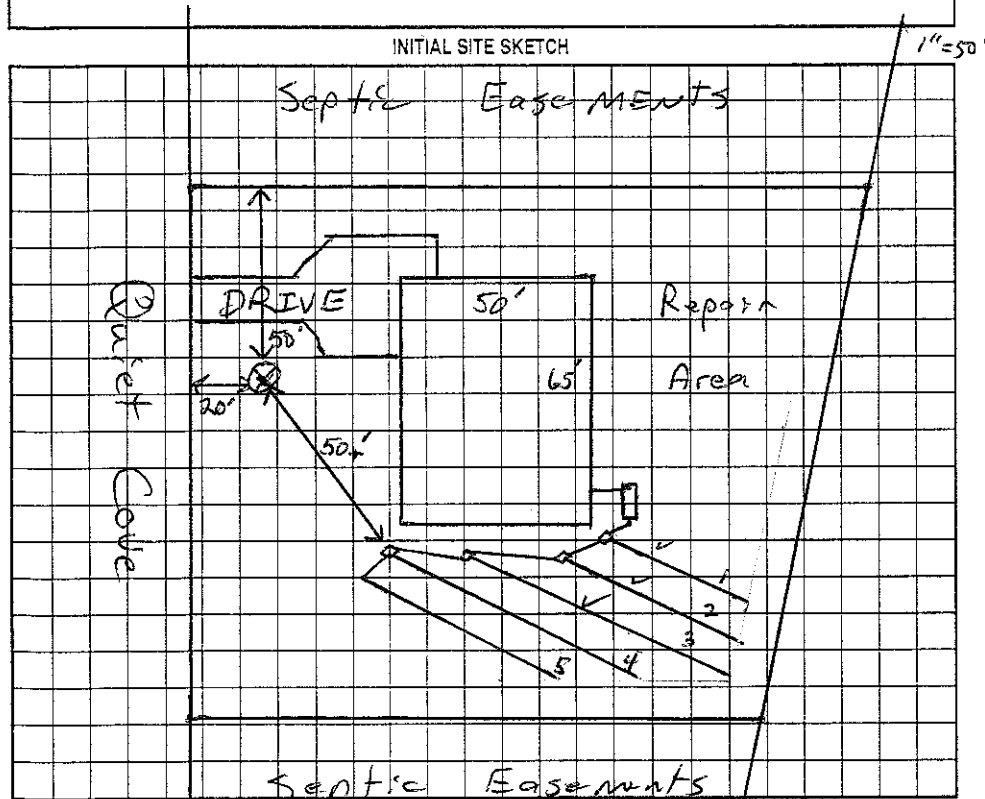

AS BUILT SKETCH

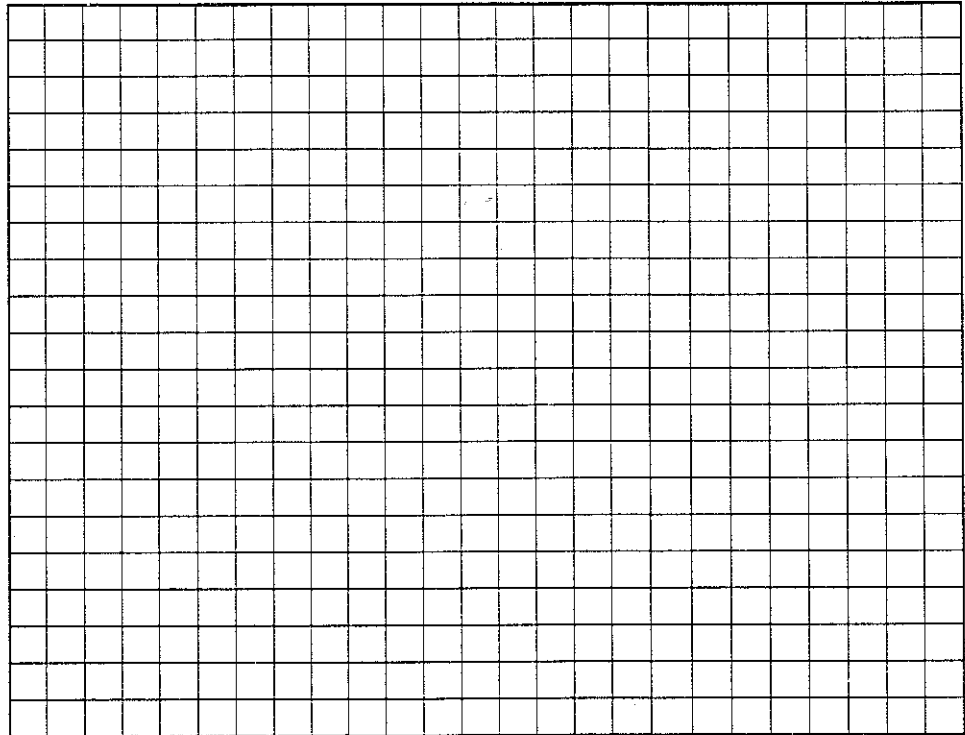

Permit can be suspended or revoked if any false information is supplied toward securing the permit/any unauthorized changes are made to the site/any unauthorized changes are made in the installation of the system. Improvement Permit with plat valid without expiration. Improvement Permit with site plan valid for sixty months. Authorization to Construct is valid for a period equal to that of Improvement Permit - not to exceed sixty months.

Signed: Ron Smith date 10/9/02 Installed by: Joe Thompson
 Improvement Permit by: G. M. R. S. date 9/12/02 Operation Permit by: G. M. R. S. date 11/24/03
 Authorization to Construct by: G. M. R. S. date 9/12/02 Existing System Inspection by: _____ date _____

HEALTH DEPT. COPY: WHITE

OWNER COPY (FINAL): YELLOW

OWNER COPY (INITIAL): PINK