

IREDELL COUNTY HEALTH DEPARTMENT

IMPROVEMENT PERMIT / CERTIFICATE OF COMPLETION / OPERATION PERMIT / EXISTING SYSTEM INSPECTION

4637079299

STATESVILLE 704-878-5305

MOORESVILLE 704-664-5281


PROPERTY DESCRIPTION NO. 19638 DATE Nov. 9, '94 TAX MAP NO. 2 L7A10 Watershed: ☒ Yes ☐ No
 OWNER OR CONTRACTOR Frank Burke Homes PHONE: Business 575-2972 Home _____
 ADDRESS 5508 BARNSDALE LN, Charlotte 28227
 LOCATION 150 W TL Quat Cove Rd. to END TL Trillingwood Ln. on Rt.
 SUBDIVISION Spring Acres BLOCK / SECTION _____ LOT 10 LOT AREA 105'x203' SITE CLASS. Bpm. 1956 DESIGN FLOW 360 gpd L.T.A.R. 1.3

Septic Tank: 1000 Gallons; STB 825 RST Date 12-2-94 ☒ New System ☐ Repair System Type: I, II, III, IV, V, VI
 Pump Tank: _____ Gallons; PT _____ Date _____ System Description: gravity conventional
 Pump Make: _____ Model _____ Serial No. _____ Repair System Description: grave PPBPS
 Nitrification Field: No Fields 1 Square Feet 1200 Linear Feet 400 Maintenance Agreement Required: ☐ Yes ☒ No
 No Lines 5 Trench Width 36" Max Trench Bottom Depth 36" Gravel Depth 12" ☐ Slab ☒ Crawl Space ☐ Basement w/plumbing ☐ Basement wo/plumbing
 Water Supply: ☒ Individual ☐ Community ☐ Public


Comments: Follow contour w/ laterals

Comments: laterals esp upper deep due to varying contour

INITIAL SITE SKETCH

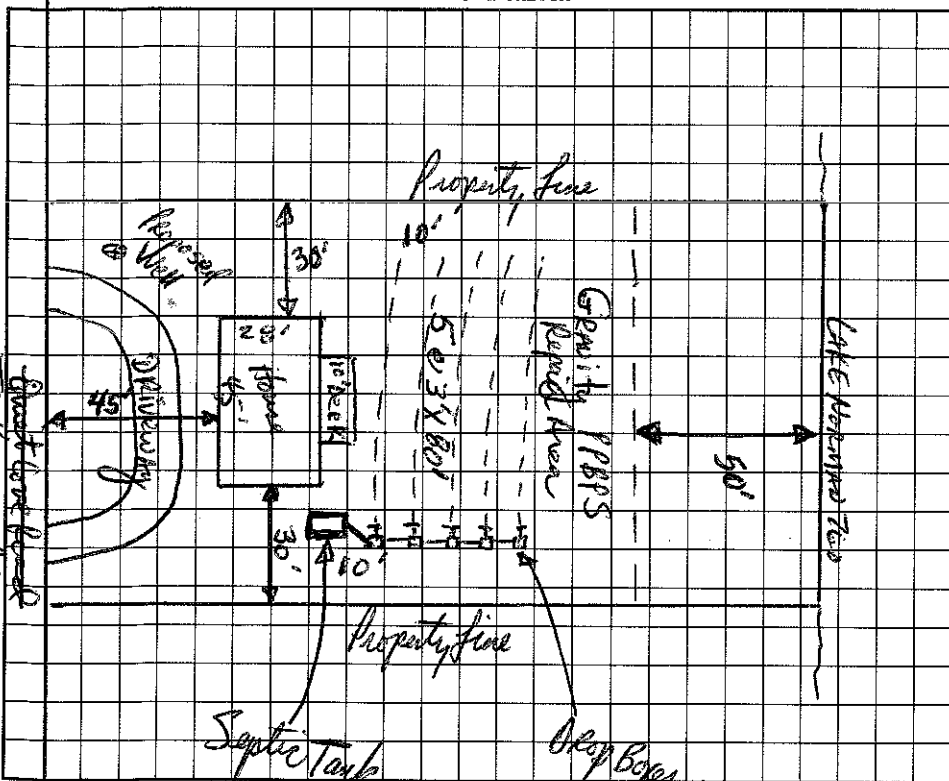

AS BUILT SKETCH

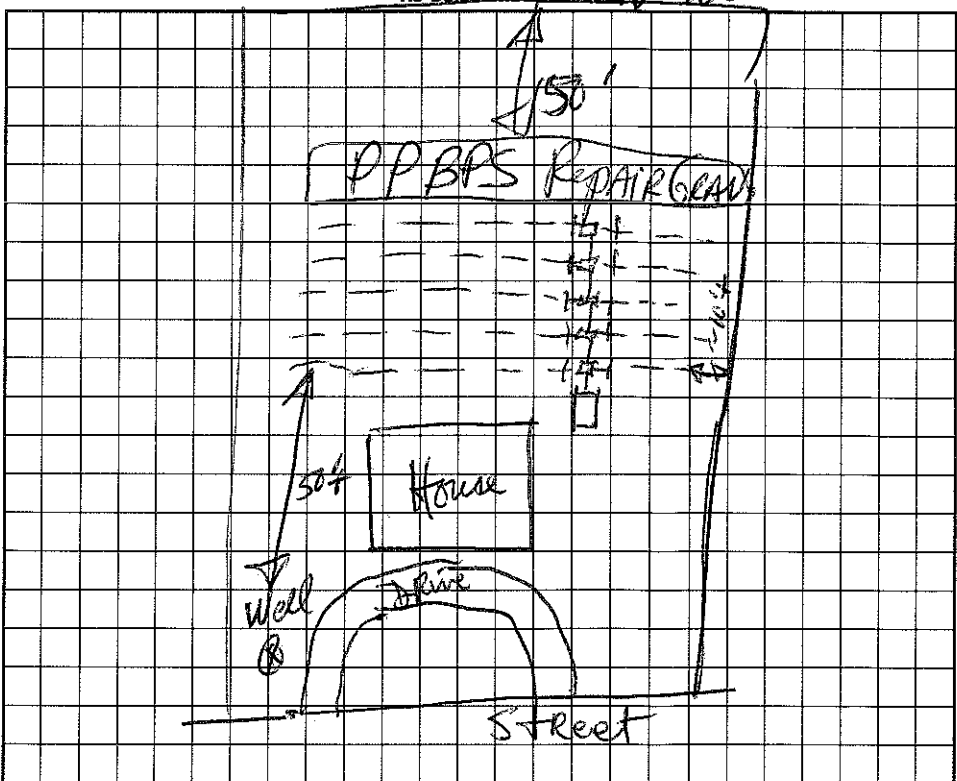

I understand that this permit can be suspended or revoked if any false information is supplied toward securing the permit/any unauthorized changes are made to the site/any unauthorized changes are made in the installation of the system. Improvement Permit is valid for 60 months from date of issuance.

Signed: Rebecca L. Burke
 Improvement Permit by: Frank R. Homes, RS date 11/9/94
 Existing System Inspection by: _____ date _____

Installed by: Carl Dunning
 Certificate of Completion by: Frank R. Homes, RS date Feb/27/95
 Operation Permit by: _____ date _____

HEALTH DEPT. COPY: WHITE

INSPECTION COPY (FINAL): GREEN

OWNER COPY (FINAL): YELLOW

INSPECTION COPY (INITIAL): PINK

OWNER COPY (INITIAL): GOLD