

IREDELL COUNTY HEALTH DEPARTMENT

IMPROVEMENT PERMIT / CERTIFICATE OF COMPLETION / OPERATION PERMIT / EXISTING SYSTEM INSPECTION

PROPERTY DESCRIPTION NO. 65935 DATE 4/24/97 TAX MAP NO. 4637082142 MOORESVILLE 704-664-5281
 OWNER OR CONTRACTOR Paul Blythe PHONE: Business _____ Home 872-0286 Watershed: ☒ Yes ☐ No
 ADDRESS 18110 NC 73 Cornelius, NC 28036
 LOCATION 150 W TL Quiet Cone Rd. on (B) before Ridge Top Rd
 SUBDIVISION Spring Acres BLOCK / SECTION III LOT 31 LOT AREA .69 AC SITE CLASS. PS DESIGN FLOW 360 L.T.A.R. .3


Septic Tank: 1000 Gallons; STB 825 Date 9/2/98 ☒ New System ☐ Repair System Type: I, II, III, IV, V, VI
 Pump Tank: _____ Gallons; PT _____ Date _____ System Description: GRAY-PANEL-16"
 Pump Make: _____ Model _____ Serial No. _____ Repair System Description: FRESMAN-CH-PLASTIC
 Nitrification Field: No Fields 1 Square Feet 420* Linear Feet 210* Maintenance Agreement Required: ☐ Yes ☒ No
 No Lines 3 Trench Width 24" Max Trench Bottom Depth 36" Gravel Depth SAND ☐ Slab ☒ Crawl Space ☐ Basement w/plumbing ☐ Basement wo/plumbing

Water Supply:
☒ Individual
☐ Community
☐ Public


Comments: EASEMENT TO FRONT AREA (FORMERLY LOT 33) REPAIR AREA ON (L) ACROSS FROM RIDGETOP RD. > 200' FROM LOT 31
OK'd - 1/24/99 - AWS

Comments:

INITIAL SITE SKETCH

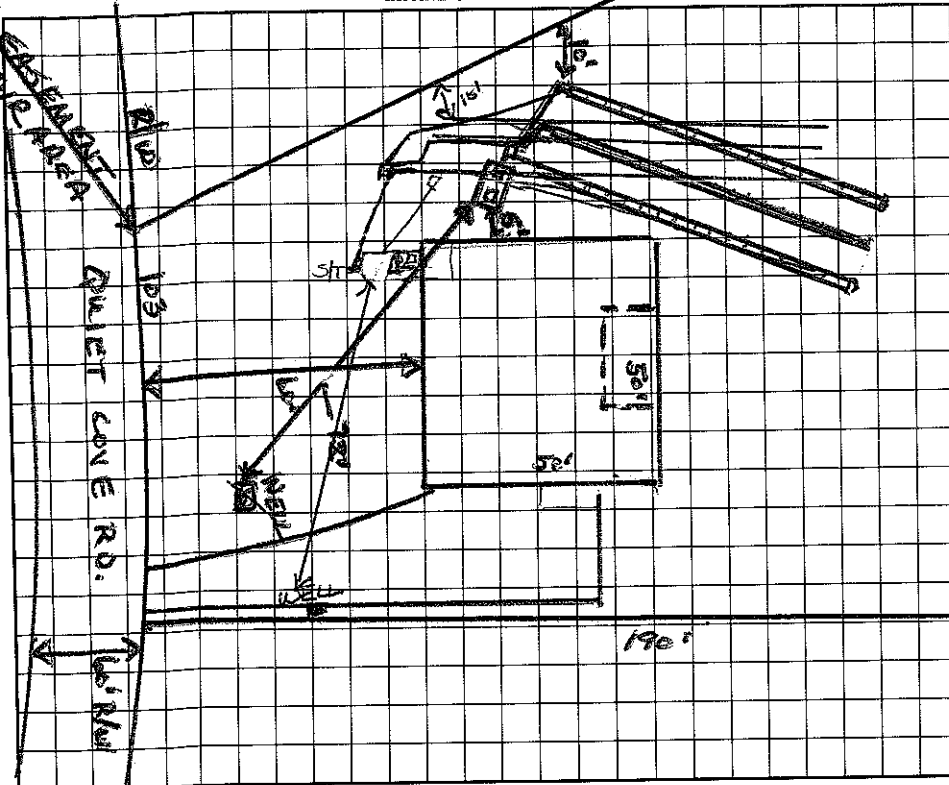

AS BUILT SKETCH

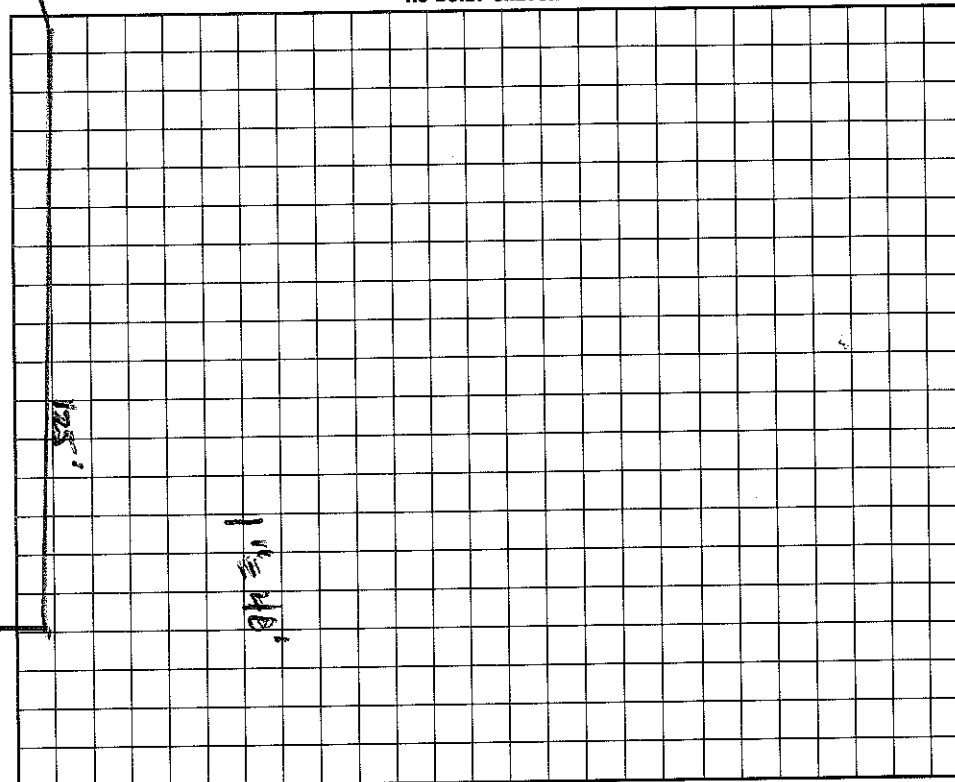

I understand that this permit can be suspended or revoked if any false information is supplied toward securing the permit/any unauthorized changes are made to the site/any unauthorized changes are made in the installation of the system. Improvement Permit is valid for 60 months from date of issuance.

Signed: * Wanda Vanderleek
 Improvement Permit by: Wesley Sparks RS date 5/5/97

Installed by: Dalbert Barton
 Certificate of Completion by: _____ date _____
 Operation Permit by: Wesley Sparks RS date 1/29/99

Existing System Inspection by: Wesley Sparks RS date 5/5/97
 HEALTH DEPT. COPY: WHITE INSPECTION COPY (FINAL): GREEN OWNER COPY (FINAL): YELLOW

INSPECTION COPY (INITIAL): PINK OWNER COPY (INITIAL): GOLD