

IREDELL COUNTY HEALTH DEPARTMENT

STATESVILLE 704-878-5305

4637082253

MOORESVILLE 704-664-5281

IMPROVEMENT PERMIT / CERTIFICATE OF COMPLETION / OPERATION PERMIT / EXISTING SYSTEM INSPECTION

PROPERTY DESCRIPTION NO. 18330 DATE OCT 25, 94 TAX MAP NO. 2L7030 Watershed: ☐ Yes ☐ No

OWNER OR CONTRACTOR Joe Fairbank Jr. PHONE: Business _____ Home _____

ADDRESS 3715 Enfieldville Rd, Kannapolis


LOCATION 150W 72 Quiet Cove Rd. on Right

SUBDIVISION Spring Acres BLOCK / SECTION _____ LOT 30 LOT AREA 108' x 190' SITE CLASS Rpm-152 DESIGN FLOW 360 gpd L.T.A.R. 0.5


Septic Tank: <u>1000</u> Gallons; STB <u>1000</u> Date <u>5-16-95</u>	☒ New System ☐ Repair System Type: I, II, III, IV, V, VI	☒ House/Mod. Home No. Bedrooms <u>3</u>	Water Supply: ☒ Individual ☐ Community ☐ Public
Pump Tank: _____ Gallons; PT _____ Date _____	System Description: <u>gravity DPBPS</u>	☐ Mobile Home No. Bathrooms <u>2</u>	
Pump Make: _____ Model _____ Serial No. _____	Repair System Description: <u>LP PPBPS</u>	☐ Business No. Employees _____	
Nitrification Field: No Fields <u>1</u> Square Feet _____ Linear Feet <u>200</u>	Maintenance Agreement Required: ☐ Yes ☒ No	☐ Other _____	
No Lines <u>3</u> Trench Width <u>24"</u> Max Trench Bottom Depth <u>36"</u>	Gravel Depth <u>NA</u> ☐ Slab ☒ Crawl Space ☐ Basement w/plumbing ☐ Basement wo/plumbing		

Comments: Follow contour w/ laterals. Problems encountered in obtaining water. This permit reflects owners desire to place new well where shown.

INITIAL SITE SKETCH

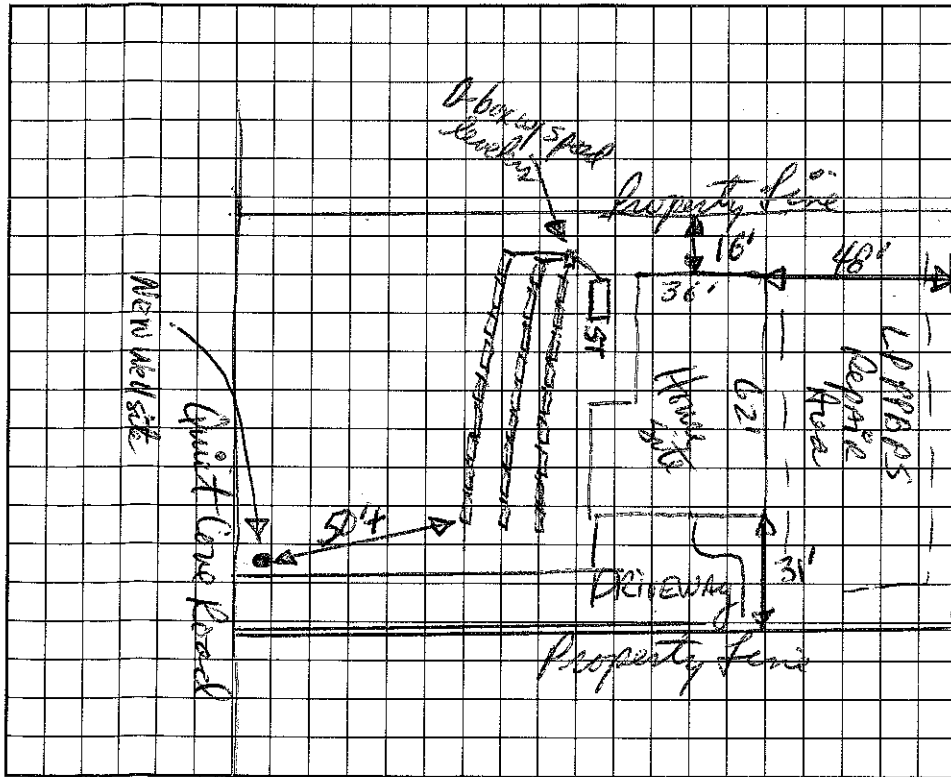

AS BUILT SKETCH

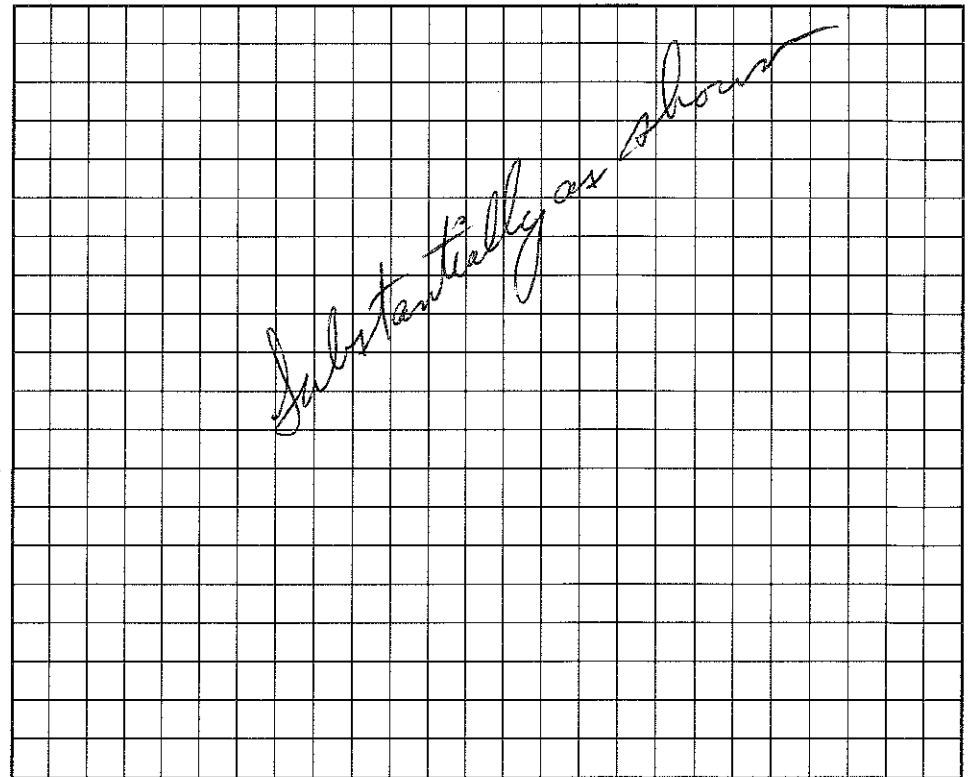

I understand that this permit can be suspended or revoked if any false information is supplied toward securing the permit/any unauthorized changes are made to the site/any unauthorized changes are made in the installation of the system. Improvement Permit is valid for 60 months from date of issuance.

Signed: Joe Fairbank Jr. Installed by: A. E. Brown

Improvement Permit by: David R. Hanson date 10/25/94 Certificate of Completion by: David R. Hanson date 7-11-95

Existing System Inspection by: _____ date _____ Operation Permit by: David R. Hanson date 7-11-95

HEALTH DEPT. COPY: WHITE

INSPECTION COPY (FINAL): GREEN

OWNER COPY (FINAL): YELLOW

INSPECTION COPY (INITIAL): PINK

OWNER COPY (INITIAL): GOLD