

IREDELL COUNTY HEALTH DEPARTMENT

IMPROVEMENT PERMIT / CERTIFICATE OF COMPLETION / OPERATION PERMIT / EXISTING SYSTEM INSPECTION

PROPERTY DESCRIPTION NO. 16893 DATE July 13, '94 TAX MAP NO. 267027 Watershed: ☒ Yes ☐ No
 OWNER OR CONTRACTOR Tom Wilson PHONE: Business _____ Home _____


ADDRESS _____
 LOCATION 150 W TL Quiet Cove Rd on Right
 SUBDIVISION Spring Acres BLOCK / SECTION II LOT 27 LOT AREA 108'x190' SITE CLASS. B per 1952 DESIGN FLOW 360 gpd L.T.A.R. 3

Septic Tank: <u>1008</u>	Gallons: <u>186</u>	STB <u>Skrap</u>	Date <u>2-11-95</u>	☒ New System ☐ Repair	System Type: I, II, III, IV, V, VI	☒ House/Mod. Home	No. Bedrooms <u>3</u>	Water Supply: ☒ Individual ☐ Community ☐ Public
Pump Tank: _____	Gallons: _____	PT _____	Date _____	System Description: <u>gravity PPBPS</u>		☐ Mobile Home	No. Bathrooms <u>2</u>	
Pump Make: _____	Model _____	Serial No. _____	_____	Repair System Description: <u>SAME</u>		☐ Business	No. Employees _____	
Nitrification Field: No Fields <u>1</u> Square Feet _____ Linear Feet <u>200</u>				Maintenance Agreement Required: ☐ Yes ☒ No		☐ Other _____	_____	
No Lines <u>3</u>	Trench Width <u>24"</u>	Max Trench Bottom Depth <u>28"</u>	Gravel Depth <u>N/A</u>	☐ Slab ☒ Crawl Space ☐ Basement w/plumbing ☐ Basement wo/plumbing				


Comments: Keep laterals shallow and on contour

Comments: Substantially as shown

INITIAL SITE SKETCH

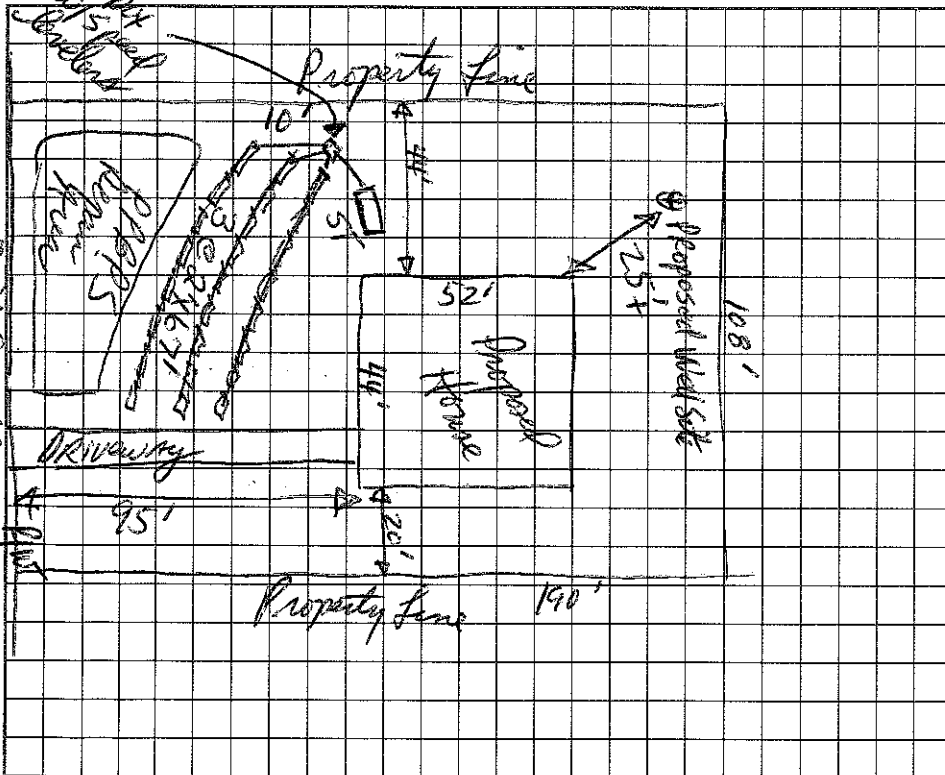

AS BUILT SKETCH

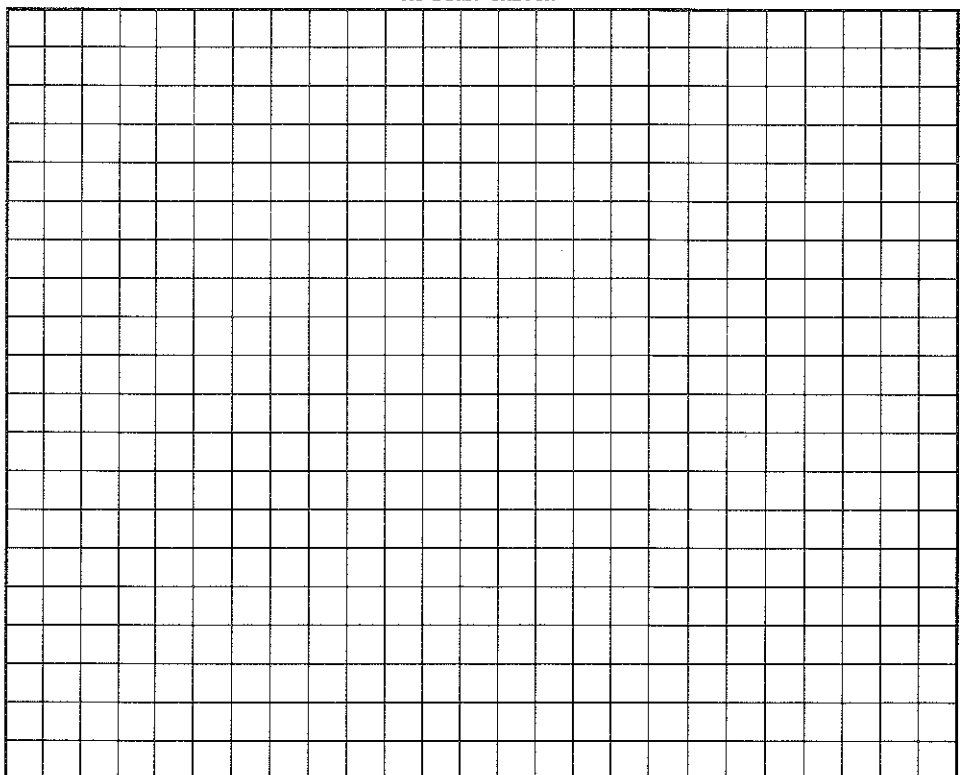

I understand that this permit can be suspended or revoked if any false information is supplied toward securing the permit/any unauthorized changes are made to the site/any unauthorized changes are made in the installation of the system. Improvement Permit is valid for 60 months from date of issuance.

Signed: [Signature]
 Improvement Permit by: [Signature] date 7/13/94
 Existing System Inspection by: _____ date _____

Installed by: Terry Jones
 Certificate of Completion by: [Signature] date 5/12/95
 Operation Permit by: [Signature] date _____

HEALTH DEPT. COPY: WHITE

INSPECTION COPY (FINAL): GREEN

OWNER COPY (FINAL): YELLOW

INSPECTION COPY (INITIAL): PINK

OWNER COPY (INITIAL): GOLD