

IMPROVEMENT PERMIT / CERTIFICATE OF COMPLETION / OPERATION PERMIT / EXISTING SYSTEM INSPECTION


PROPERTY DESCRIPTION NO. 21897 DATE 11/2/95 TAX MAP NO. 227 D 39 Watershed: ☒ Yes ☐ No
OWNER OR CONTRACTOR Mark Harper PHONE: Business 478-3766 Home _____
ADDRESS 1451 Lake Forest Dr. Catawba, NC. 28609
LOCATION Spring Creek Lot 39
SUBDIVISION Spring Creek BLOCK / SECTION II LOT 39 LOT AREA .54 AC SITE CLASS. PS DESIGN FLOW 340 L.T.A.R. 3

Septic Tank: <u>1000</u> Gallons; STB <u>756</u> Date <u>9/20/96</u>	☒ New System ☐ Repair System Type: I, II, III, IV, V, VI	☒ House/Mod. Home No. Bedrooms <u>3</u>	Water Supply: ☒ Individual
Pump Tank: _____ Gallons; PT _____ Date _____	System Description: <u>CONV - A Box</u>	☐ Mobile Home No. Bathrooms <u>2.5</u>	☐ Community
Pump Make: _____ Model _____ Serial No. _____	Repair System Description: <u>Same PANEL</u>	☐ Business No. Employees _____	☐ Public
Nitrification Field: No Fields <u>1</u> Square Feet <u>1200</u> Linear Feet <u>400</u>	Maintenance Agreement Required: ☐ Yes ☒ No	☐ Other _____	
No Lines <u>5</u> Trench Width <u>36"</u> Max Trench Bottom Depth <u>36"</u> Gravel Depth <u>12"</u>	☐ Slab ☒ Crawl Space ☐ Basement w/plumbing ☐ Basement wo/plumbing		


Comments:	81	52
		61
		64
		71

Comments	(DRIVEWAY NOT IN AT TIME OF INSPECTION)

INITIAL SITE SKETCH 810

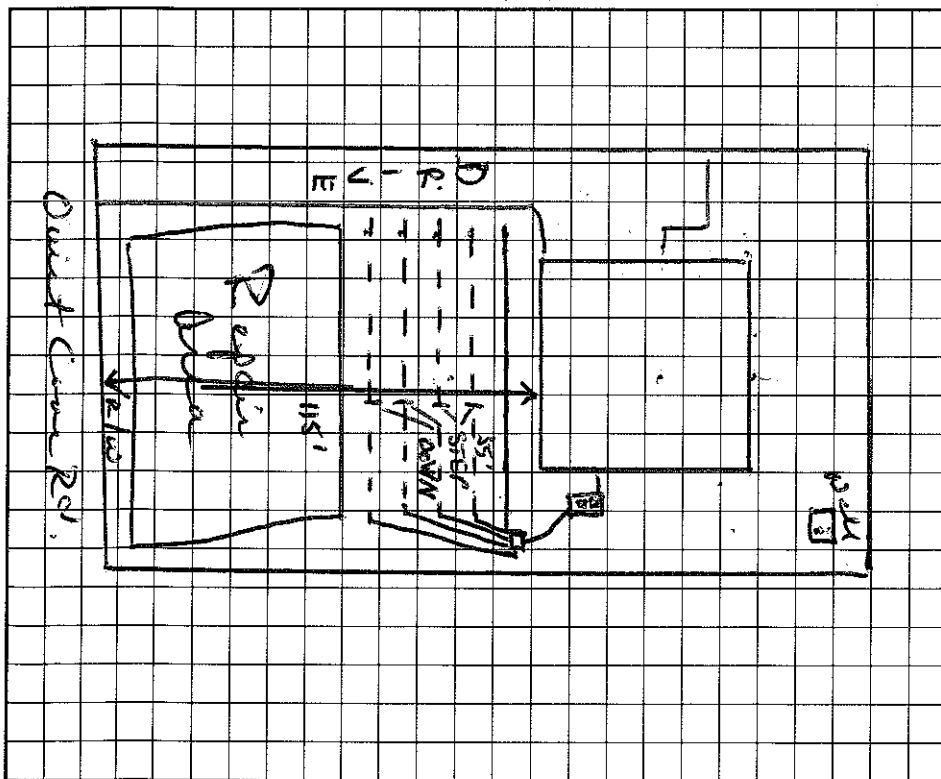

AS BUILT SKETCH

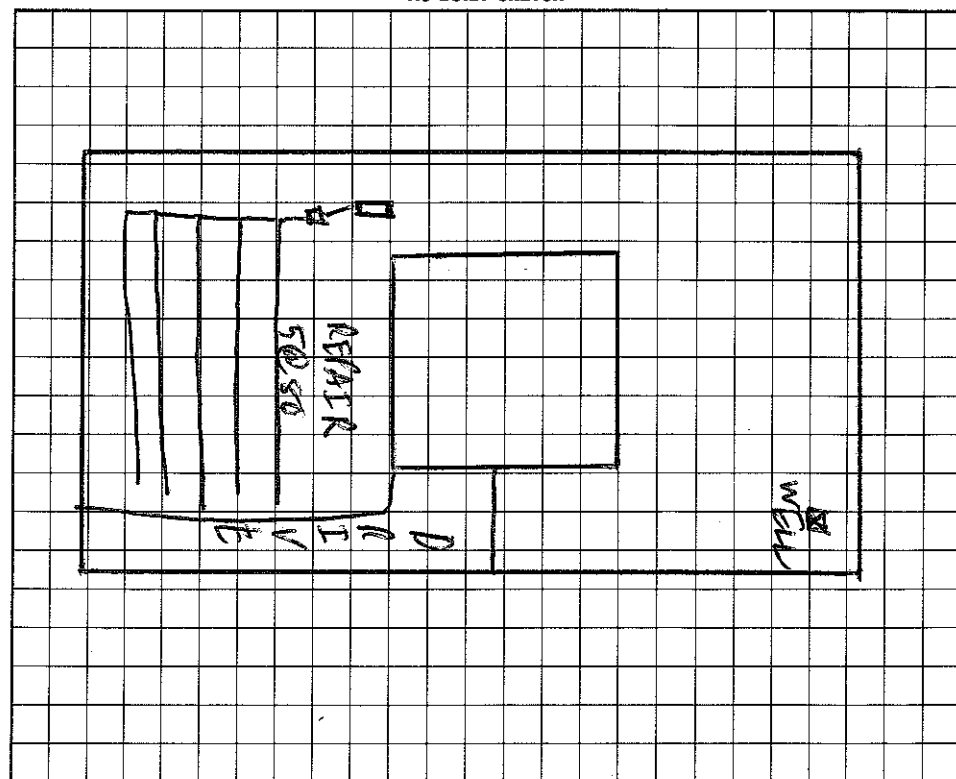

I understand that this permit can be suspended or revoked if any false information is supplied toward securing the permit/any unauthorized changes are made to the site/any unauthorized changes are made in the installation of the system.

Signed: 11/16/95
Improvement Permit by: Wesley Sparks RS date 11/21/95
Existing System Inspection by: Construct Wesley Sparks RS date 11/21/95

Installed by: KENNEDY C-RAIDING
Certificate of Completion by: _____ date _____
Operation Permit by: C B. J. Fennel EWS date 12/11/96

HEALTH DEPT. COPY: WHITE

INSPECTION COPY (FINAL): GREEN

OWNER COPY (FINAL): YELLOW

INSPECTION COPY INITIALY: PINK

OWNER COPY (INITIAL): GOLD