

IREDELL COUNTY HEALTH DEPARTMENT

STATESVILLE 704-878-5305

MOORESVILLE 704-664-5281

IMPROVEMENT PERMIT / CERTIFICATE OF COMPLETION / OPERATION PERMIT / EXISTING SYSTEM INSPECTION

PROPERTY DESCRIPTION NO. 16870 DATE 9-22-93 TAX MAP NO. 21-37-D-74
 OWNER OR CONTRACTOR THOMAS WILSON PHONE: Business 704 663 5115 Home _____
 ADDRESS RT 4 Box 11 Mooresville NC 28115
 LOCATION Hwy 150 W of Mooresville approx 3 miles West of I-77 on Southside of 150 just before left fronting Tullahoma Lane
 SUBDIVISION Spring Acres BLOCK / SECTION II LOT 24 LOT AREA 23,100 SITE CLASS. P L.T.A.R. 2.3


**DEVELOPER
PERMIT**

Water Supply: ☒ Individual ☐ Community ☐ Public
 Septic Tank: 1000 Gallons; STB 794 Date 10/15/94
 Pump Tank: NA Gallons; PT _____ Date _____
 Nitrification Field: No Fields 1 Square Feet 1200 Linear Feet 400
 No Lines 5 Trench Width 36" Trench Depth 24" Gravel Depth 12"
☒ New System ☐ Repair System Type: I, II, IV, V, VI
 System Description: gravity conventional
 Repair System Description: gravity PPOPS
 Maintenance Agreement Required: ☐ Yes ☒ No


☒ House/Mod. Home No. Bedrooms 3 Garbage Disposal: ☒ Yes ☐ No
☐ Mobile Home No. Bathrooms 2 Auto. Dishwasher: ☐ Yes ☐ No
☐ Business No. Employees _____ Auto. Washing Machine: ☒ Yes ☐ No
☐ Other _____ Other _____
☒ Slab ☐ Crawl Space ☐ Basement w/plumbing ☐ Basement wo/plumbing

Comments Do not install during wet soil conditions in rain.

INITIAL SITE SKETCH 1"=50'

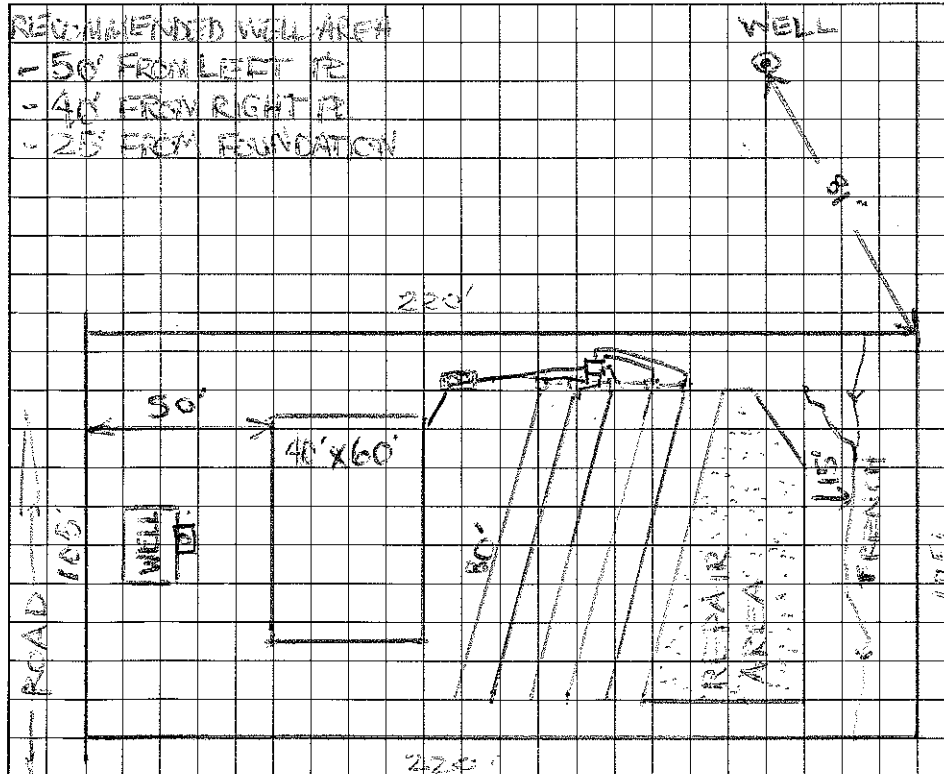

AS BUILT SKETCH

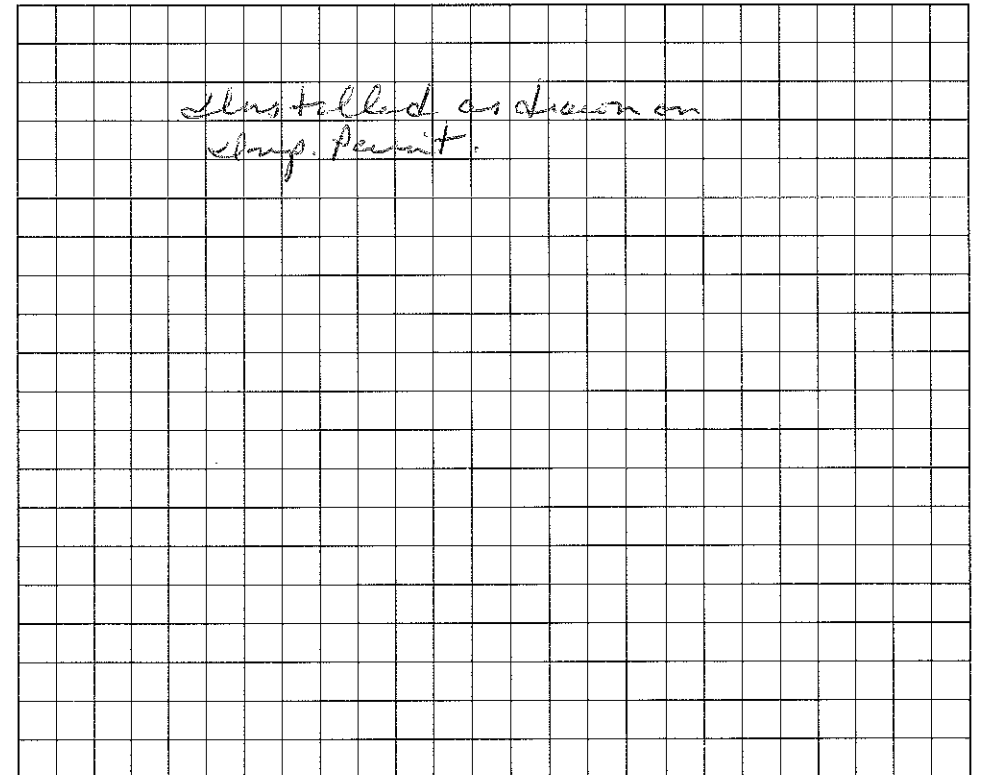

I understand that this permit can be suspended or revoked if any false information is supplied toward securing the permit/any unauthorized changes are made to the site/any unauthorized changes are made in the installation of the system. Improvement Permit is valid for 60 months from date of issuance.

Signed: Vanda Foreing
 Improvement Permit by: Antonia Lamon date 9-22-93
 Existing System Inspection by: _____ date _____
 Installed by: Mike Donaldson
 Certificate of Completion by: Wesley Sparks RS date 12/8/94
 Operation Permit by: _____ date _____

HEALTH DEPT. COPY: WHITE

INSPECTION COPY (FINAL): GREEN

OWNER COPY (FINAL): YELLOW

INSPECTION COPY (INITIAL): PINK

OWNER COPY (INITIAL): GOLD