

IREDELL COUNTY HEALTH DEPARTMENT

IMPROVEMENT PERMIT / CERTIFICATE OF COMPLETION / OPERATION PERMIT / EXISTING SYSTEM INSPECTION

4637086188

STATESVILLE 704-878-5305

MOORESVILLE 704-664-5281

PROPERTY DESCRIPTION NO. 17545 DATE Dec 14 '93 TAX MAP NO. 2L7D 43 Watershed: ☒ Yes ☐ No
 OWNER OR CONTRACTOR Eddie Jacks PHONE: Business 892-7373 Home _____
 ADDRESS 20220 Fox Rd. Davidson
 LOCATION 150W Tl. Quiet Cove Rd. Tl. Trallingwood Ln. ~500' on Right
 SUBDIVISION Spring Acres BLOCK / SECTION _____ LOT 43 LOT AREA ~105 X 208' SITE CLASS. RS DESIGN FLOW 360 gpd L.T.A.R. .3


Septic Tank: 1000 Gallons; STB 794 Bellinger Date 3-16-94 ☒ New System ☐ Repair System Type: I, II, III, IV, V, VI
 Pump Tank: _____ Gallons; PT _____ Date _____ System Description: gravity conventional
 Pump Make: _____ Model _____ Serial No. _____ Repair System Description: gen. PPBPS
 Nitrification Field: No Fields 1 Square Feet 1200 Linear Feet 400 Maintenance Agreement Required: ☐ Yes ☒ No
 No Lines 4 Trench Width 36" Max Trench Bottom Depth 36" Gravel Depth 12" ☐ Slab ☒ Crawl Space ☐ Basement w/plumbing ☐ Basement wo/plumbing

Water Supply:
☒ Individual
☐ Community
☐ Public


Comments: Exit plumbing at or slightly above existing grade in order to accommodate specified trench bottom depth. Follow contour with laterals.

Comments:

INITIAL SITE SKETCH

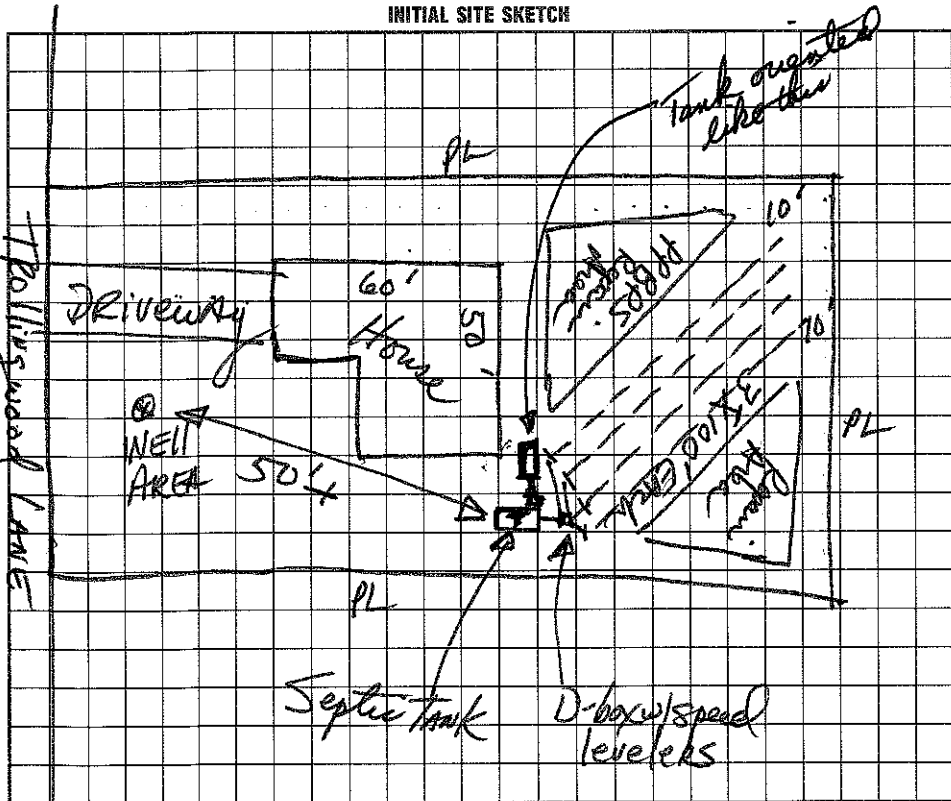

AS BUILT SKETCH

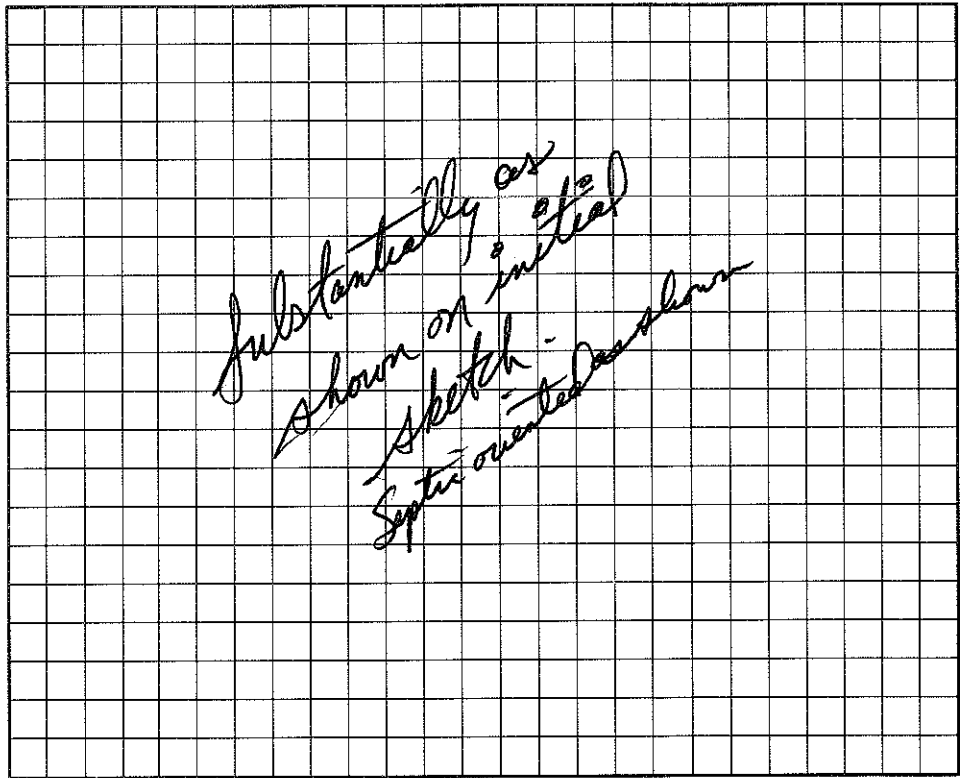

I understand that this permit can be suspended or revoked if any false information is supplied toward securing the permit/any unauthorized changes are made to the site/any unauthorized changes are made in the installation of the system. Improvement Permit is valid for 60 months from date of issuance.

Signed: Jeana Dugger
 Improvement Permit by: David R. Hinson, RS. date 12/14/93
 Existing System Inspection by: _____ date _____
 Installed by: David R. Hinson, RS
 Certificate of Completion by: David R. Hinson, RS date 5/16/94
 Operation Permit by: _____ date _____

HEALTH DEPT. COPY: WHITE

INSPECTION COPY (FINAL): GREEN

OWNER COPY (FINAL): YELLOW

INSPECTION COPY (INITIAL): PINK

OWNER COPY (INITIAL): GOLD