

IREDELL COUNTY HEALTH DEPARTMENT

IMPROVEMENT PERMIT / AUTHORIZATION TO CONSTRUCT / OPERATION PERMIT / EXISTING SYSTEM INSPECTION

STATESVILLE 704-878-5305

MOORESVILLE 704-664-5281

PERMIT# 066509 PIN# 464481479 4644379701

OWNER OR CONTRACTOR Crescent Resources / Mark Jacobs PHONE: Business 964-6436 Home 892-5975 DATE 11/9/99

ADDRESS P.O. Box 1003 Charlotte, NC 28201

LOCATION Langtree Tr Macklyn Tr West Paces Rd

SUBDIVISION Westview BLOCK / SECTION LOT 23 LOT AREA 1.02 Acre SITE CLASS. PS DESIGN FLOW 480 gpd L.T.A.R. .3

Septic Tank: 1000 Gallons; STB 794 Date 12-26-99 ☒ New System ☐ Repair System Type: I, II, III, IV, V, VI

Pump Tank: Gallons; PT Date ☐ House/Mod. Home No. Bedrooms 4

Pump Make: Model Serial No. ☐ Mobile Home No. Bathrooms 4

Nitrification Field: No Fields 1 Square Feet 900 Linear Feet 300 ☐ Business No. Employees

No Lines 6 at 50' Trench Width 36" Max Trench Bottom Depth 30" Maintenance Agreement Required: ☐ Yes ☒ No ☐ Other

Gravel Depth N/A ☐ Slab ☒ Crawl Space ☐ Basement w/plumbing ☐ Basement wo/plumbing


Comments/Conditions: Keep Septic System at least 10' from PL, 50' from lake 50' from private well

A 100' from Community well.


Comments/Conditions: Replaces permit dated 4/23/99

Installed QS Drawn

INITIAL SITE SKETCH Scale 1:50

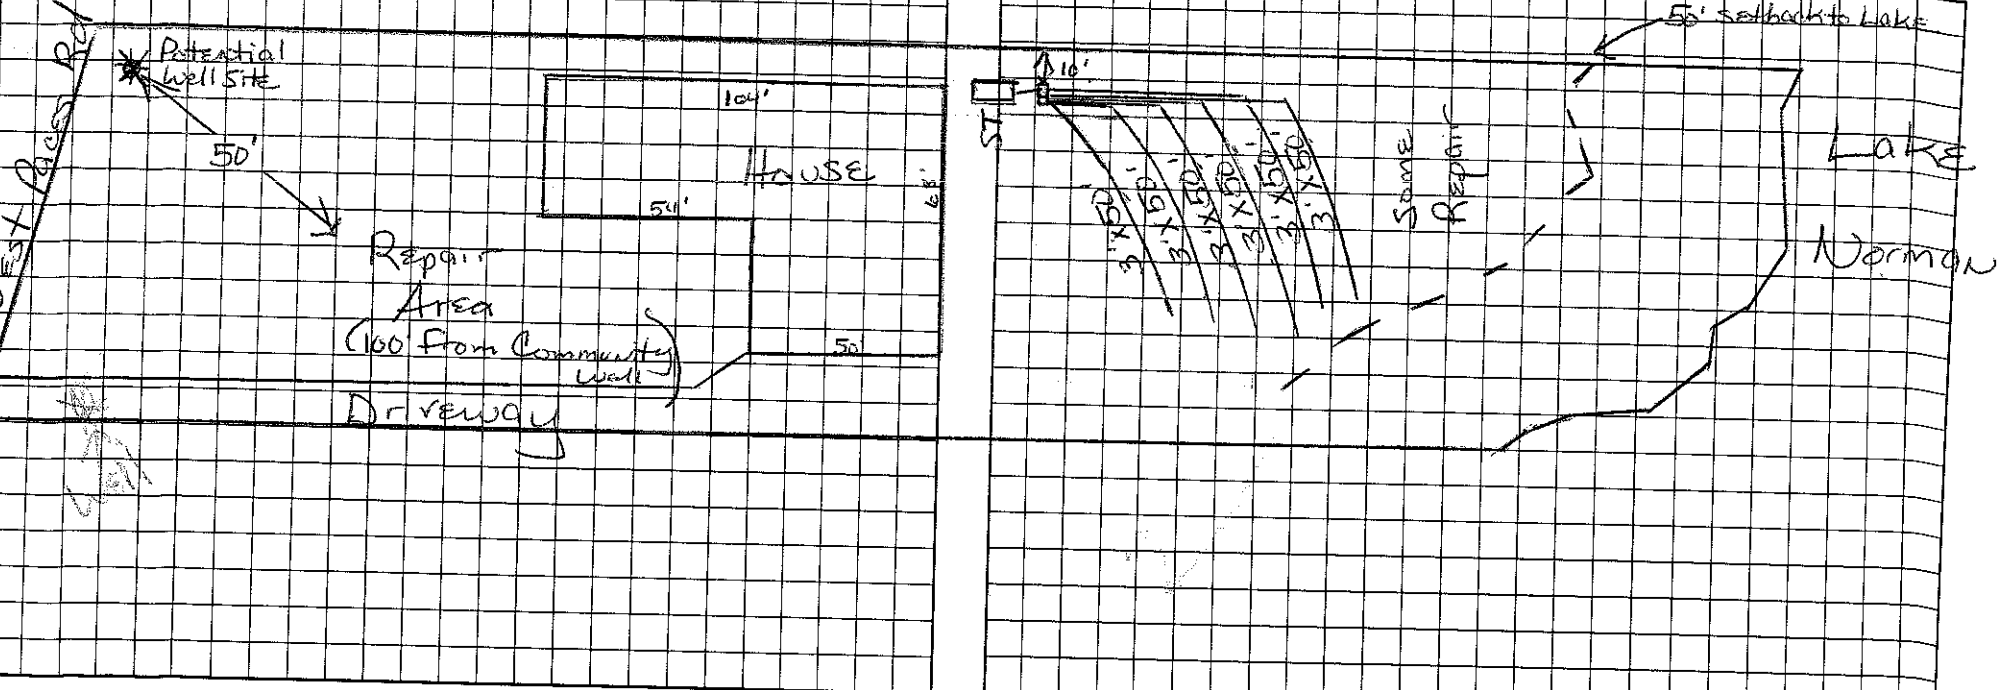

AS BUILT SKETCH

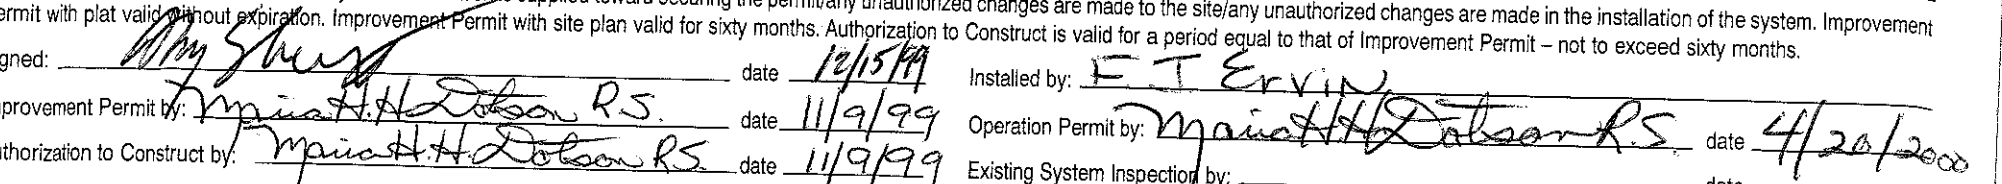

Permit can be suspended or revoked if any false information is supplied toward securing the permit/any unauthorized changes are made to the site/any unauthorized changes are made in the installation of the system. Improvement Permit with plat valid without expiration. Improvement Permit with site plan valid for sixty months. Authorization to Construct is valid for a period equal to that of Improvement Permit - not to exceed sixty months.

Signed: [Signature] date 12/15/99 Installed by: F T Ervin

Improvement Permit by: Maia H. H. Tolson R.S. date 11/9/99 Operation Permit by: Maia H. H. Tolson R.S. date 4/20/2000

Authorization to Construct by: Maia H. H. Tolson R.S. date 11/9/99 Existing System Inspection by: date

HEALTH DEPT. COPY: WHITE

OWNER COPY (FINAL): YELLOW

OWNER COPY (INITIAL): PINK